


Briarwood Avenue Drainage Upgrade

Drainage As-Built Plans - Revision D

Document BA-DGN-PLN-011 | Status: Record Drawing | Datum: BWD 2026 | Issue date: 18 May 2026

Revision D record drawings supersede the 2019 GIS asset register and the tender-stage drainage sketch. Use these plans for pipe geometry, manhole sequence, inverts, lengths and C-01 culvert geometry. Do not infer easement availability from this drawing package.

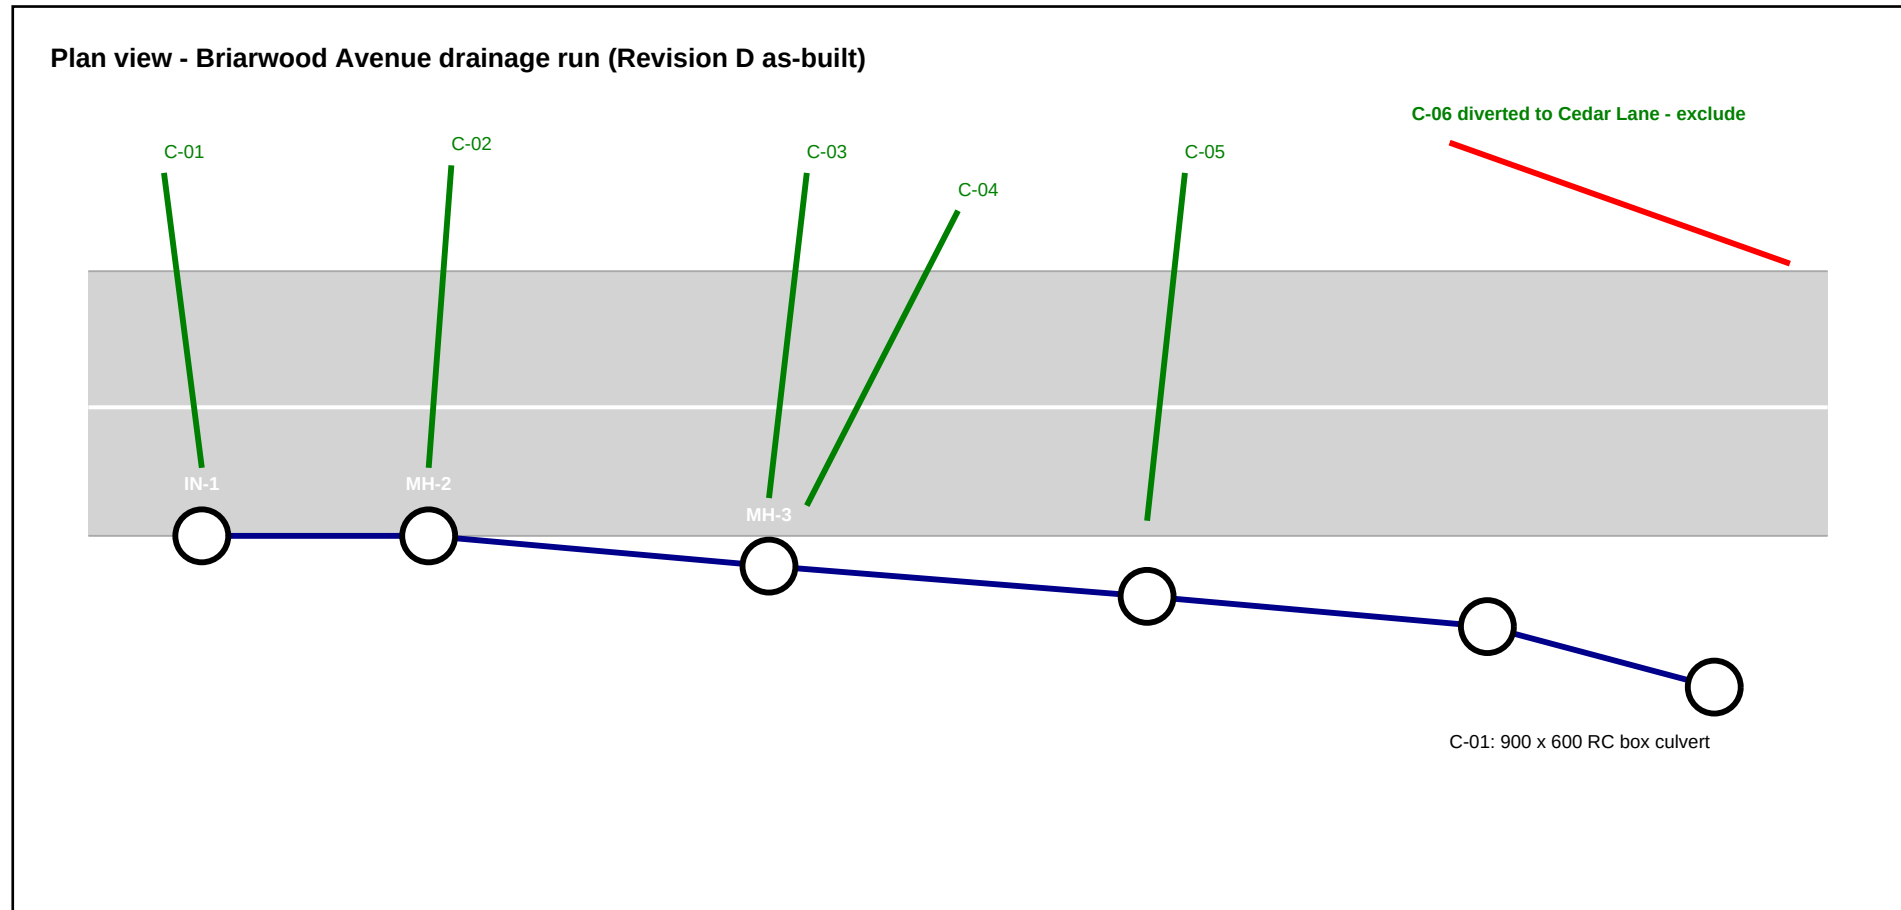


Key drawing note: Revision D controls pipe geometry, node sequence, inverts, lengths and C-01 culvert geometry. C-06 is shown only as excluded context.

Sheet C-203: Pipe Schedule and Structure Data

Run	From	To	Length m	Size / shape	Material	Upstream invert m	Downstream invert m	Slope %	Control note
P-12	IN-1	MH-2	30.0	375 mm circular	RCP	85.594	84.804	2.63	Local inlet lead only
P-23	MH-2	MH-3	78.1	600 mm circular	RCP	84.804	84.438	0.47	Supersedes GIS 450 mm value
P-34	MH-3	MH-4	92.2	675 mm circular	RCP	84.438	83.762	0.73	Use Rev D length and inverts
P-45	MH-4	MH-5	85.9	750 mm circular	RCP	83.762	82.936	0.96	Sediment observed; capacity calculation still uses cleaned pipe
C-01	MH-5	OUT-1	34.1	900 x 600 box	RC box	82.936	82.836	0.29	Use HDS-5 culvert method

Profile sketch - invert chainage and manhole rim elevations

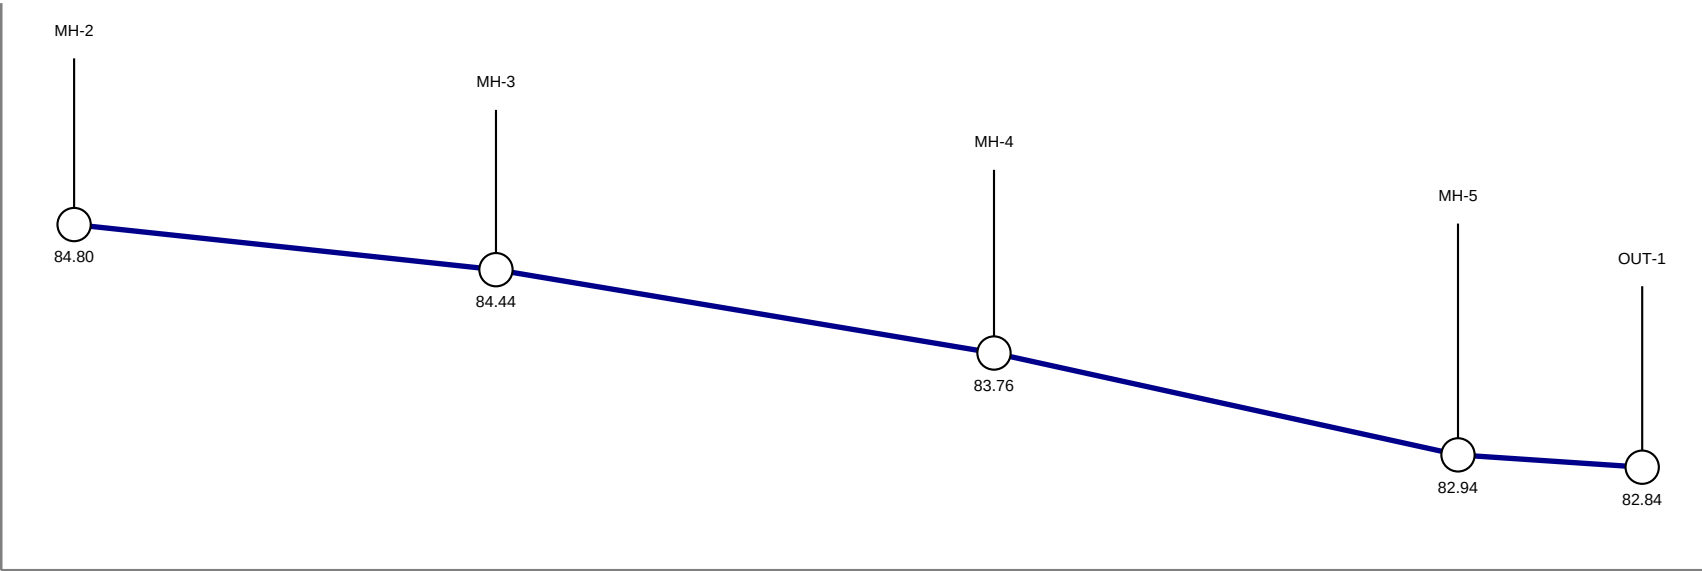

Elevations shown in BWD 2026. Survey raw levels require +0.42 m before use.

Manhole rim elevations from this sheet should be checked against the corrected survey register. Where the survey register and this sheet differ by less than 0.03 m after datum correction, use the corrected survey rim for HGL freeboard and the Rev D plan invert for pipe profile.

Sheet C-401: C-01 Culvert Inlet and Outlet Detail

Parameter	Record value	Use in model
Culvert ID	C-01	Outlet control and inlet-control check
Shape	Rectangular reinforced-concrete box	Use 0.90 m span x 0.60 m rise
Barrel length	34.1 m	Use for outlet-control and energy-loss estimate
Inlet invert	82.936 m BWD 2026	At MH-5 discharge to culvert
Outlet invert	82.836 m BWD 2026	At receiving channel
Manning n	0.013	Concrete barrel, unless CCTV proves rougher condition
Entrance condition	square-edge headwall with minor wingwall chamfer	Use standard HDS-5 square-edge coefficient unless later detail proves bevelled edge
Provisional tailwater	83.05 m BWD 2026	From field high-water mark; survey confirmation open item

Detail notes

Note	Instruction
D-01	Field inspection on 15 May 2026 could not confirm the barrel shape because the outlet was partially submerged. The as-built box-culvert detail remains controlling for 60% design.
D-02	CCTV inspection is required before construction release to confirm barrel obstruction and lining feasibility.
D-03	Tailwater of 83.05 m is provisional. Do not remove the tailwater verification open item unless a receiving-channel survey is provided.

Sheet C-502: Legacy Conflicts to Reconcile

Conflict ID	Superseded or incomplete evidence	Governing plan evidence	Required use
PLN-01	2019 GIS asset register lists MH-2 to MH-3 as 450 mm pipe.	Sheet C-203 Revision D lists P-23 as 600 mm RCP.	Use 600 mm RCP for hydraulic capacity and HGL calculations.
PLN-02	Tender sketch BA-TDR-2019-02 shows MH-3 to MH-4 slope as 0.42%.	Sheet C-203 Revision D gives revised inverts and 0.73% slope.	Use Rev D inverts and slope.
PLN-03	Inspection note says C-01 appears circular from outlet view.	Sheet C-401 Revision D details C-01 as 900 x 600 reinforced-concrete box.	Use box culvert geometry and record CCTV as open item.
PLN-04	2019 catchment boundary includes C-06 east apron.	Plan note shows C-06 diverted to Cedar Lane by 2025 curb works.	Exclude C-06 from Briarwood Rational Method calculation.

Reviewer instruction

When modelled HGL or option screening conflicts with these drawings, cite the exact sheet and conflict ID. Unresolved facts must remain in the open-item register instead of being assumed closed.